




SCALE 1 : 1
KEY PLAN SHOWING REAR SEATING
AREA IN RELATION TO RESTAURANT

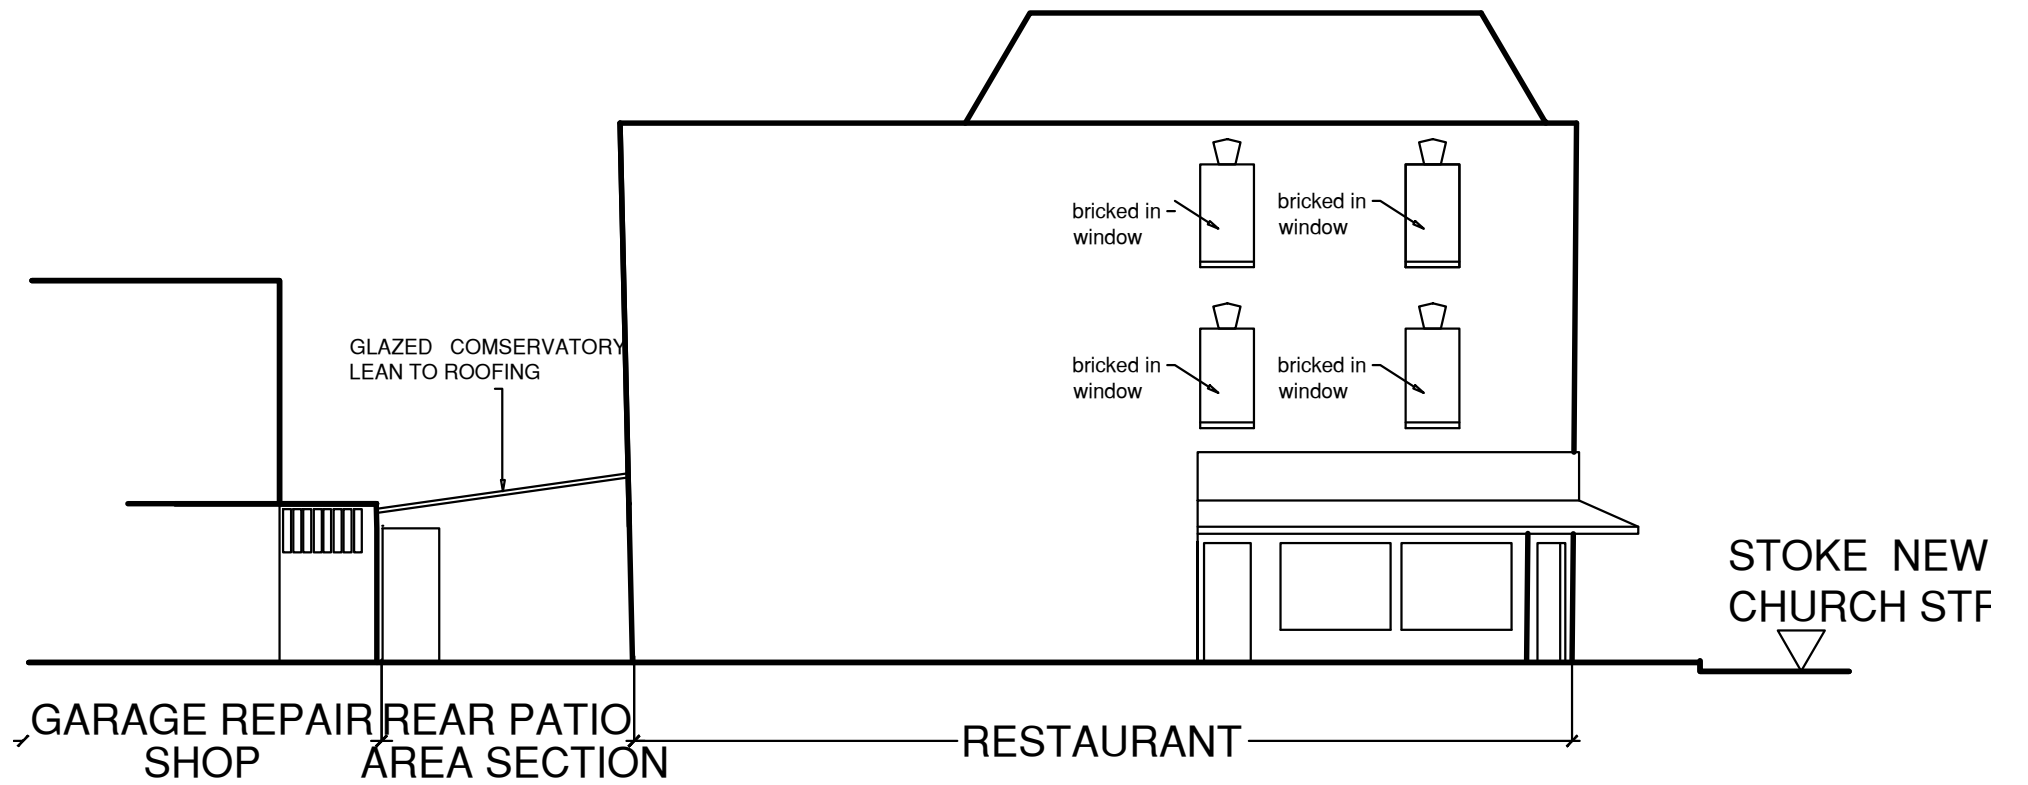

DEFOE ROAD ELEVATION

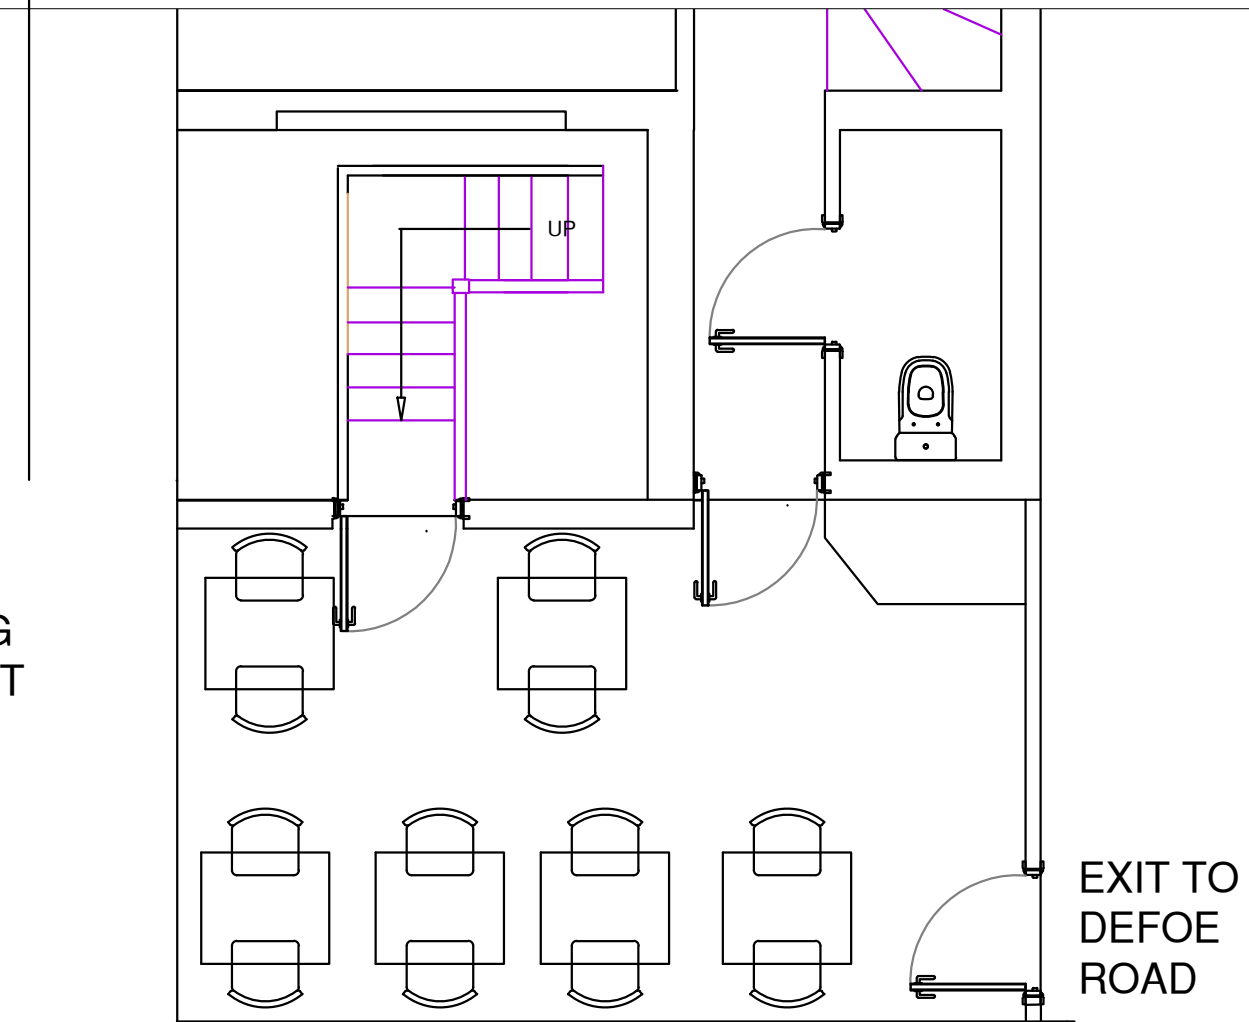

SCALE 1 : 50 REAR SEATING AREA
PART PLAN

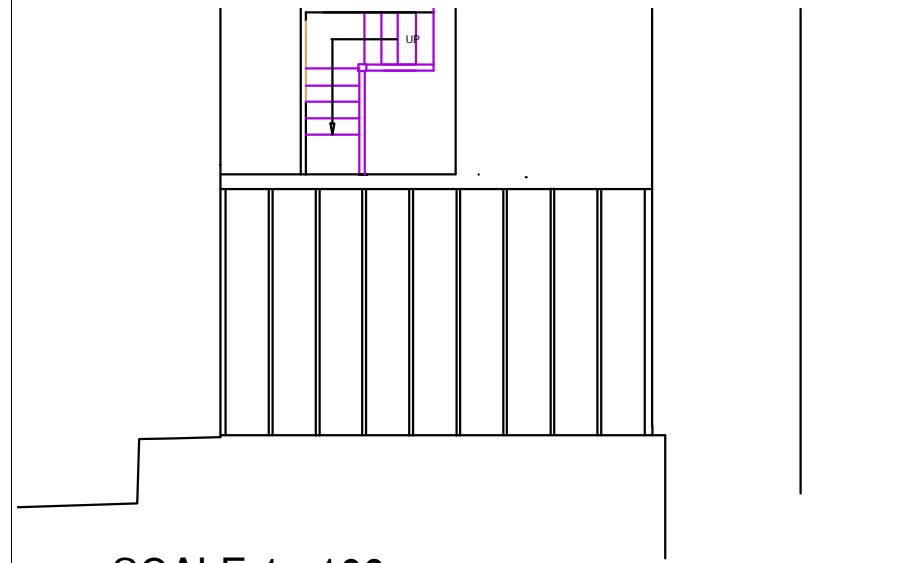

SCALE 1:100
GLAZED CONSERVATORY RPPF PLAN
AS BUILT

SCALE BAR 1:50 1000mm 2000mm 3000mm 2000mm 4000mm 6000mm	SCALE	DRAWING NO.	REV	DATE	DWG
	1:100/50	34/321/04	A	11/01/2019	CG
SCALE BAR 1:100	SITE DIMENSIONS TO BE CHECKED ON SITE BEFORE SITE WORKS START				
DRAWING TITLE	PAPER size	PROJECT		DESIGN-TECT email: mail@designtect.co.uk 35 Milton Road, London. W7 1LQ. Ph 020 3623 4202	
PLANS AND ELEVATION AS BUILT	A3	97 STOKE NEWINGTON CHURCH STREET			
	STATUS SUR/DWG	LONDON N16 0UD			