



SCALE 1 : 100
 EXISTING REAR GARDEN PATIO AREA
 NOTE NO ROOF COVERING OVER

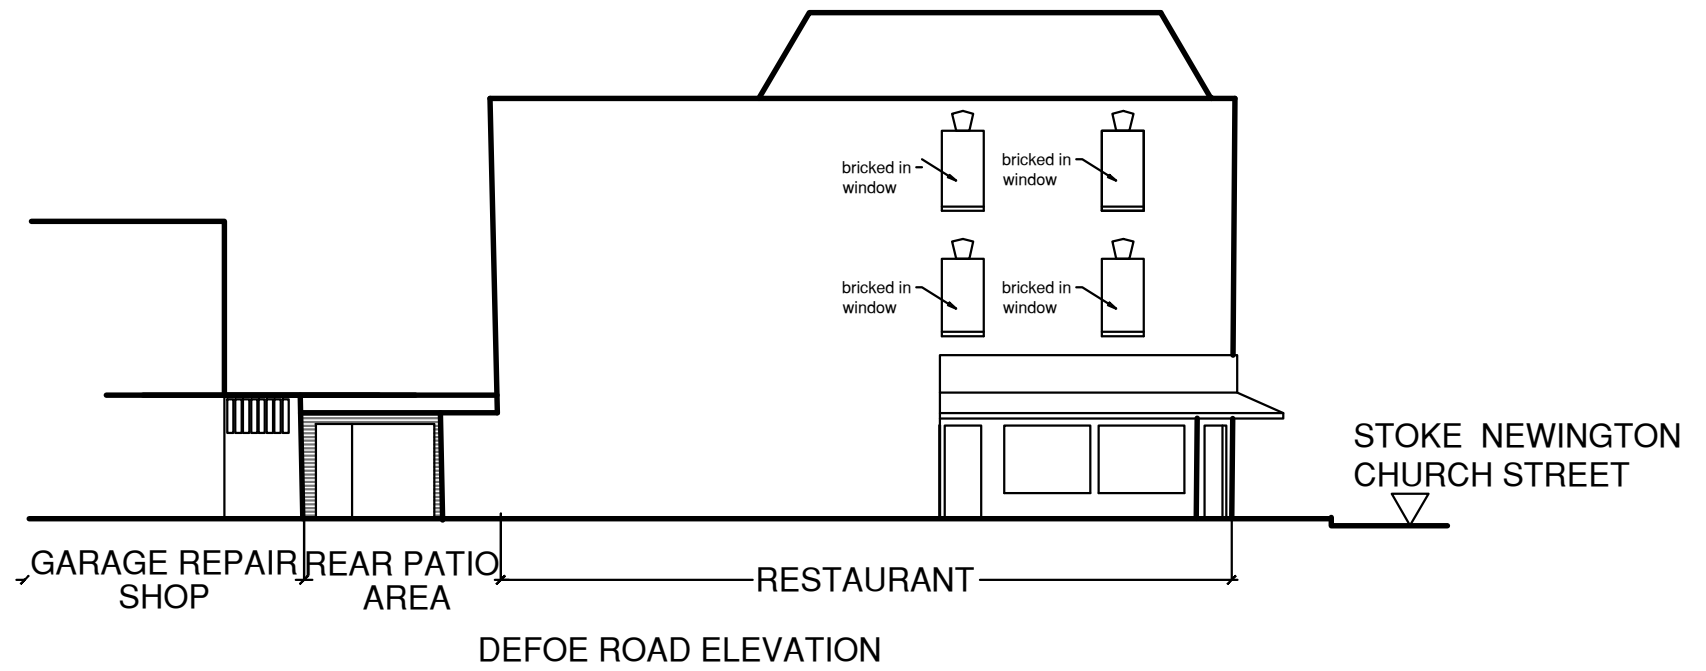

DEFOE ROAD ELEVATION

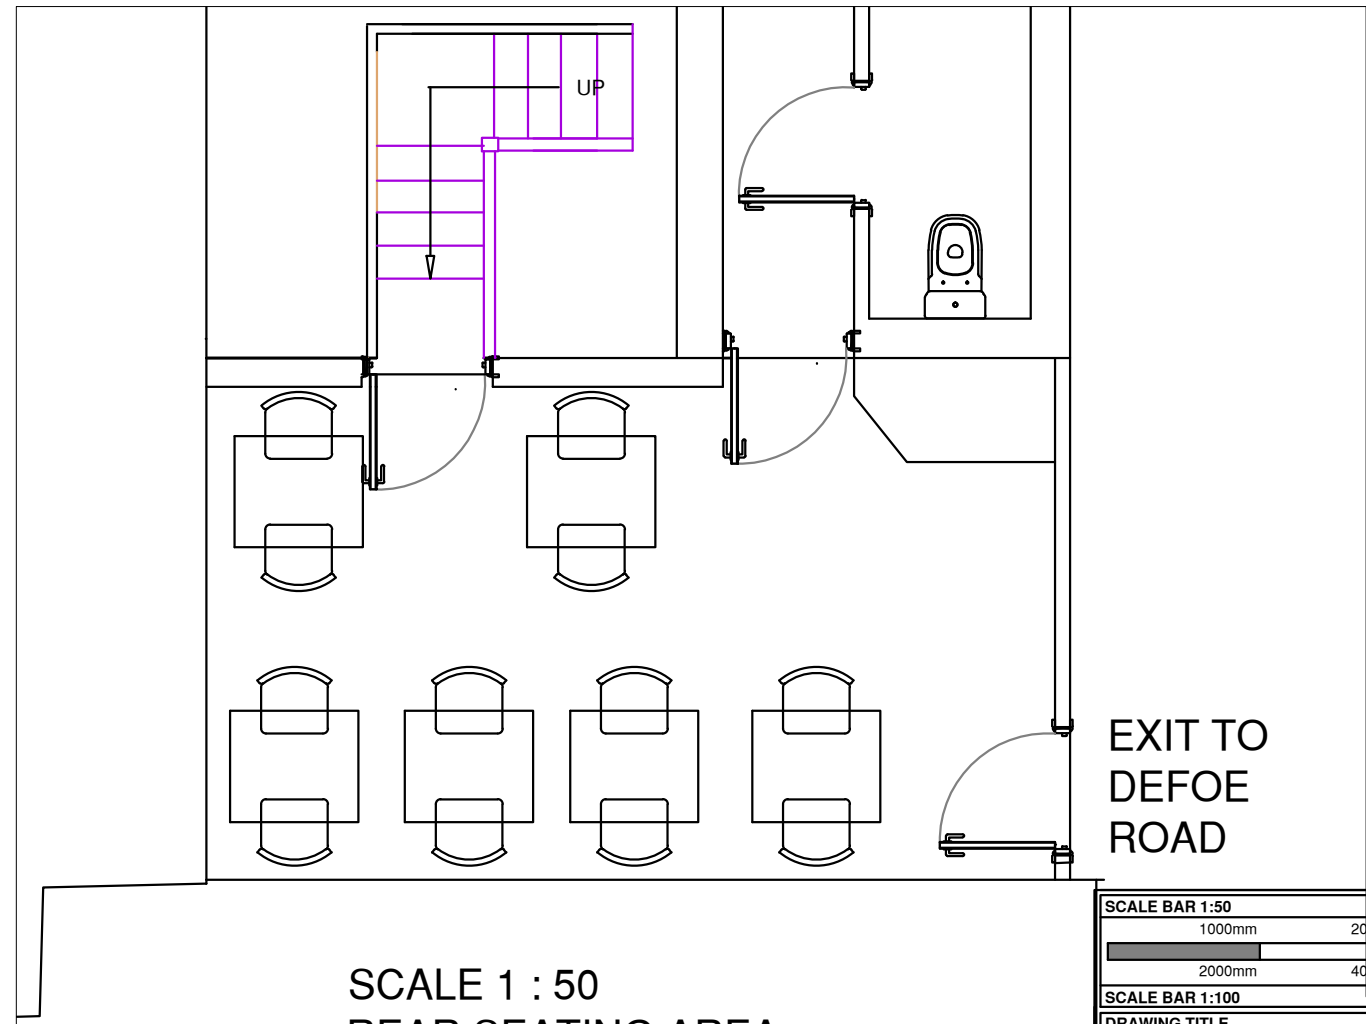

SCALE 1 : 50
 REAR SEATING AREA
 PART PLAN

SCALE BAR 1:50 1000mm 2000mm 3000mm 2000mm 4000mm 6000mm		SCALE 1:100/50	DRAWING NO. 34/321/03	REV A	DATE 11/01/2019	DWG CG
SCALE BAR 1:100 SITE DIMENSIONS TO BE CHECKED ON SITE BEFORE SITE WORKS START						
DRAWING TITLE PLANS AND ELEVATION AS BUILT		PAPER SIZE A3	PROJECT 97 STOKE NEWINGTON CHURCH STREET LONDON N16 0UD		DESIGN-TECT email: mail@designtect.co.uk 35 Milton Road, London. W7 1LQ. Ph 020 3623 4202	
		STATUS SUR/DWG				