


PRE-EXISTING ROOF PLAN (NO ROOF)

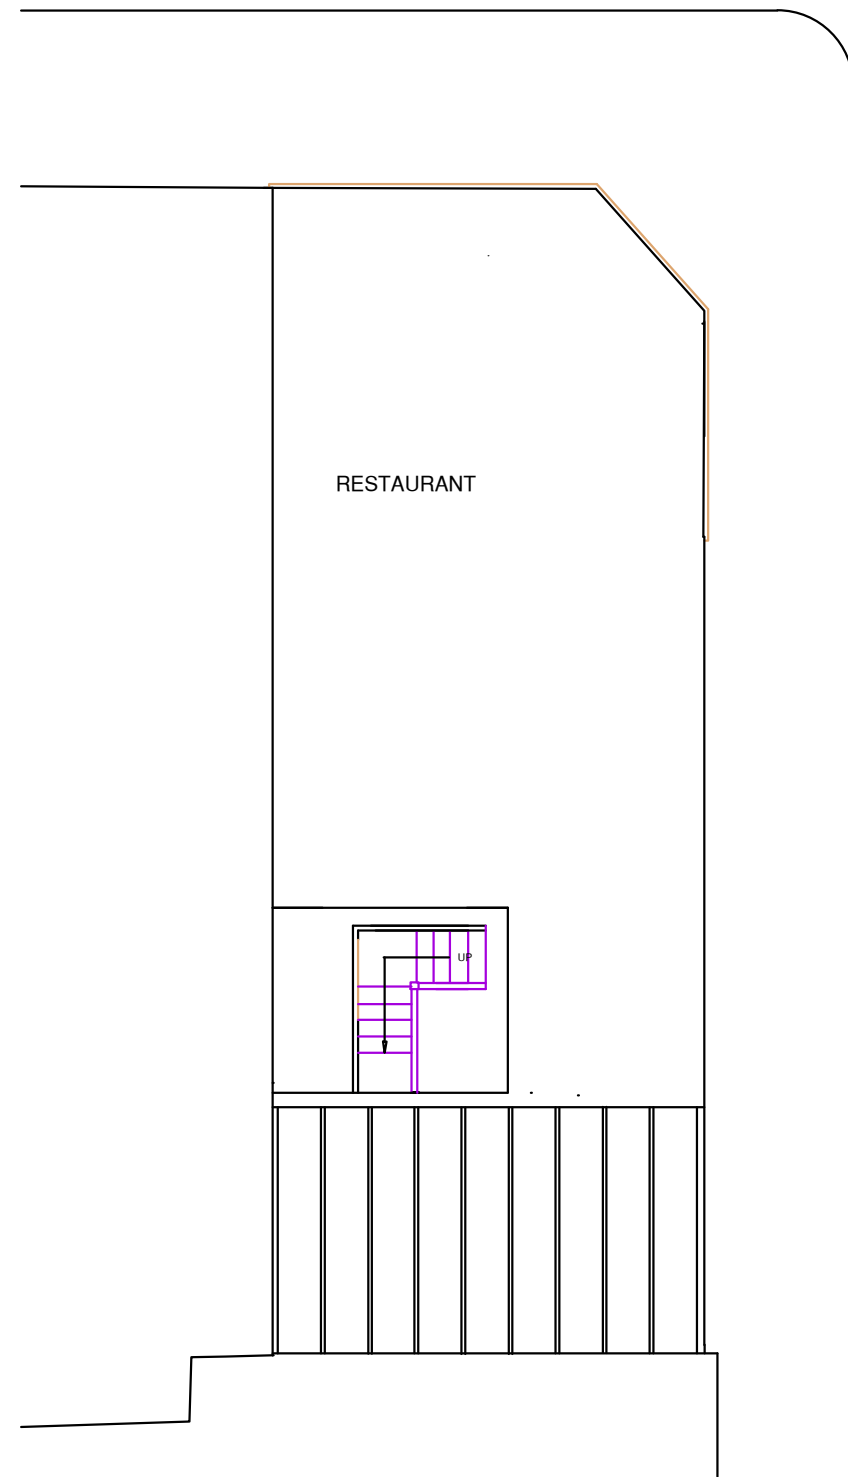

AS BUILT ROOF PLAN

<b>SCALE BAR 1:50</b> 		<b>SCALE</b> 1 : 100	<b>DRAWING NO.</b> 34/321/06	<b>REV</b> -	<b>DATE</b> 11/01/2019	<b>DWG</b> CG
<b>SCALE BAR 1:100</b> 		SITE DIMENSIONS TO BE CHECKED ON SITE BEFORE SITE WORKS START				
<b>DRAWING TITLE</b> ROOF PLAN PRE- EXISTING AND AS BUILT		<b>PAPER size</b> A3	<b>PROJECT</b> 97 STOKE NEWINGTON CHURCH STREET LONDON N16 0UD		<b>DESIGN-TECT</b> email: mail@designtect.co.uk 35 Milton Road, London. W7 1LQ. Ph 020 3623 4202	
		<b>STATUS</b> SUR/DWG				